

CONFERENCE & RECREATION ROOM
(MODULE A6)
(SEE DWG. 00661-311-A06-001)

LAUNDRY & RESTROOM
(MODULE A5)
(SEE DWG. 00661-311-A05-001)

GYM & LOCKER ROOM
(MODULE A4)
(SEE DWG. 00661-311-A04-001)

& ELECTRICAL ROOM
(MODULE A3)
(SEE DWG. 00661-311-A03-001)

FRESH WATER TANK #3
(MODULE A2)
(SEE DWG. 00661-311-A02-001)


FRESH WATER TANK #1 & #2
(MODULE A1)
(SEE DWG. 00661-311-A01-001)

LEVEL 1

0	AS BUILT	RG	12/01/15
REV	DESCRIPTION	CH BY	DATE
	REVISIONS		

This drawing shall not be used or reproduced in any manner, nor shall any similar drawings or structures be made herefrom, nor shall the information hereon be used for any purpose other than that for which it is released without the written consent of an officer of

TITLE					
30 MODULE ACOMODATIONS 1ST LEVEL KEY PLAN					
SCALE	DWN BY	CHKD BY	APPR ENG	APP BY	
NONE	ZBC	ABD	HX	RMB	
DRAWING NUMBER					
REV No					

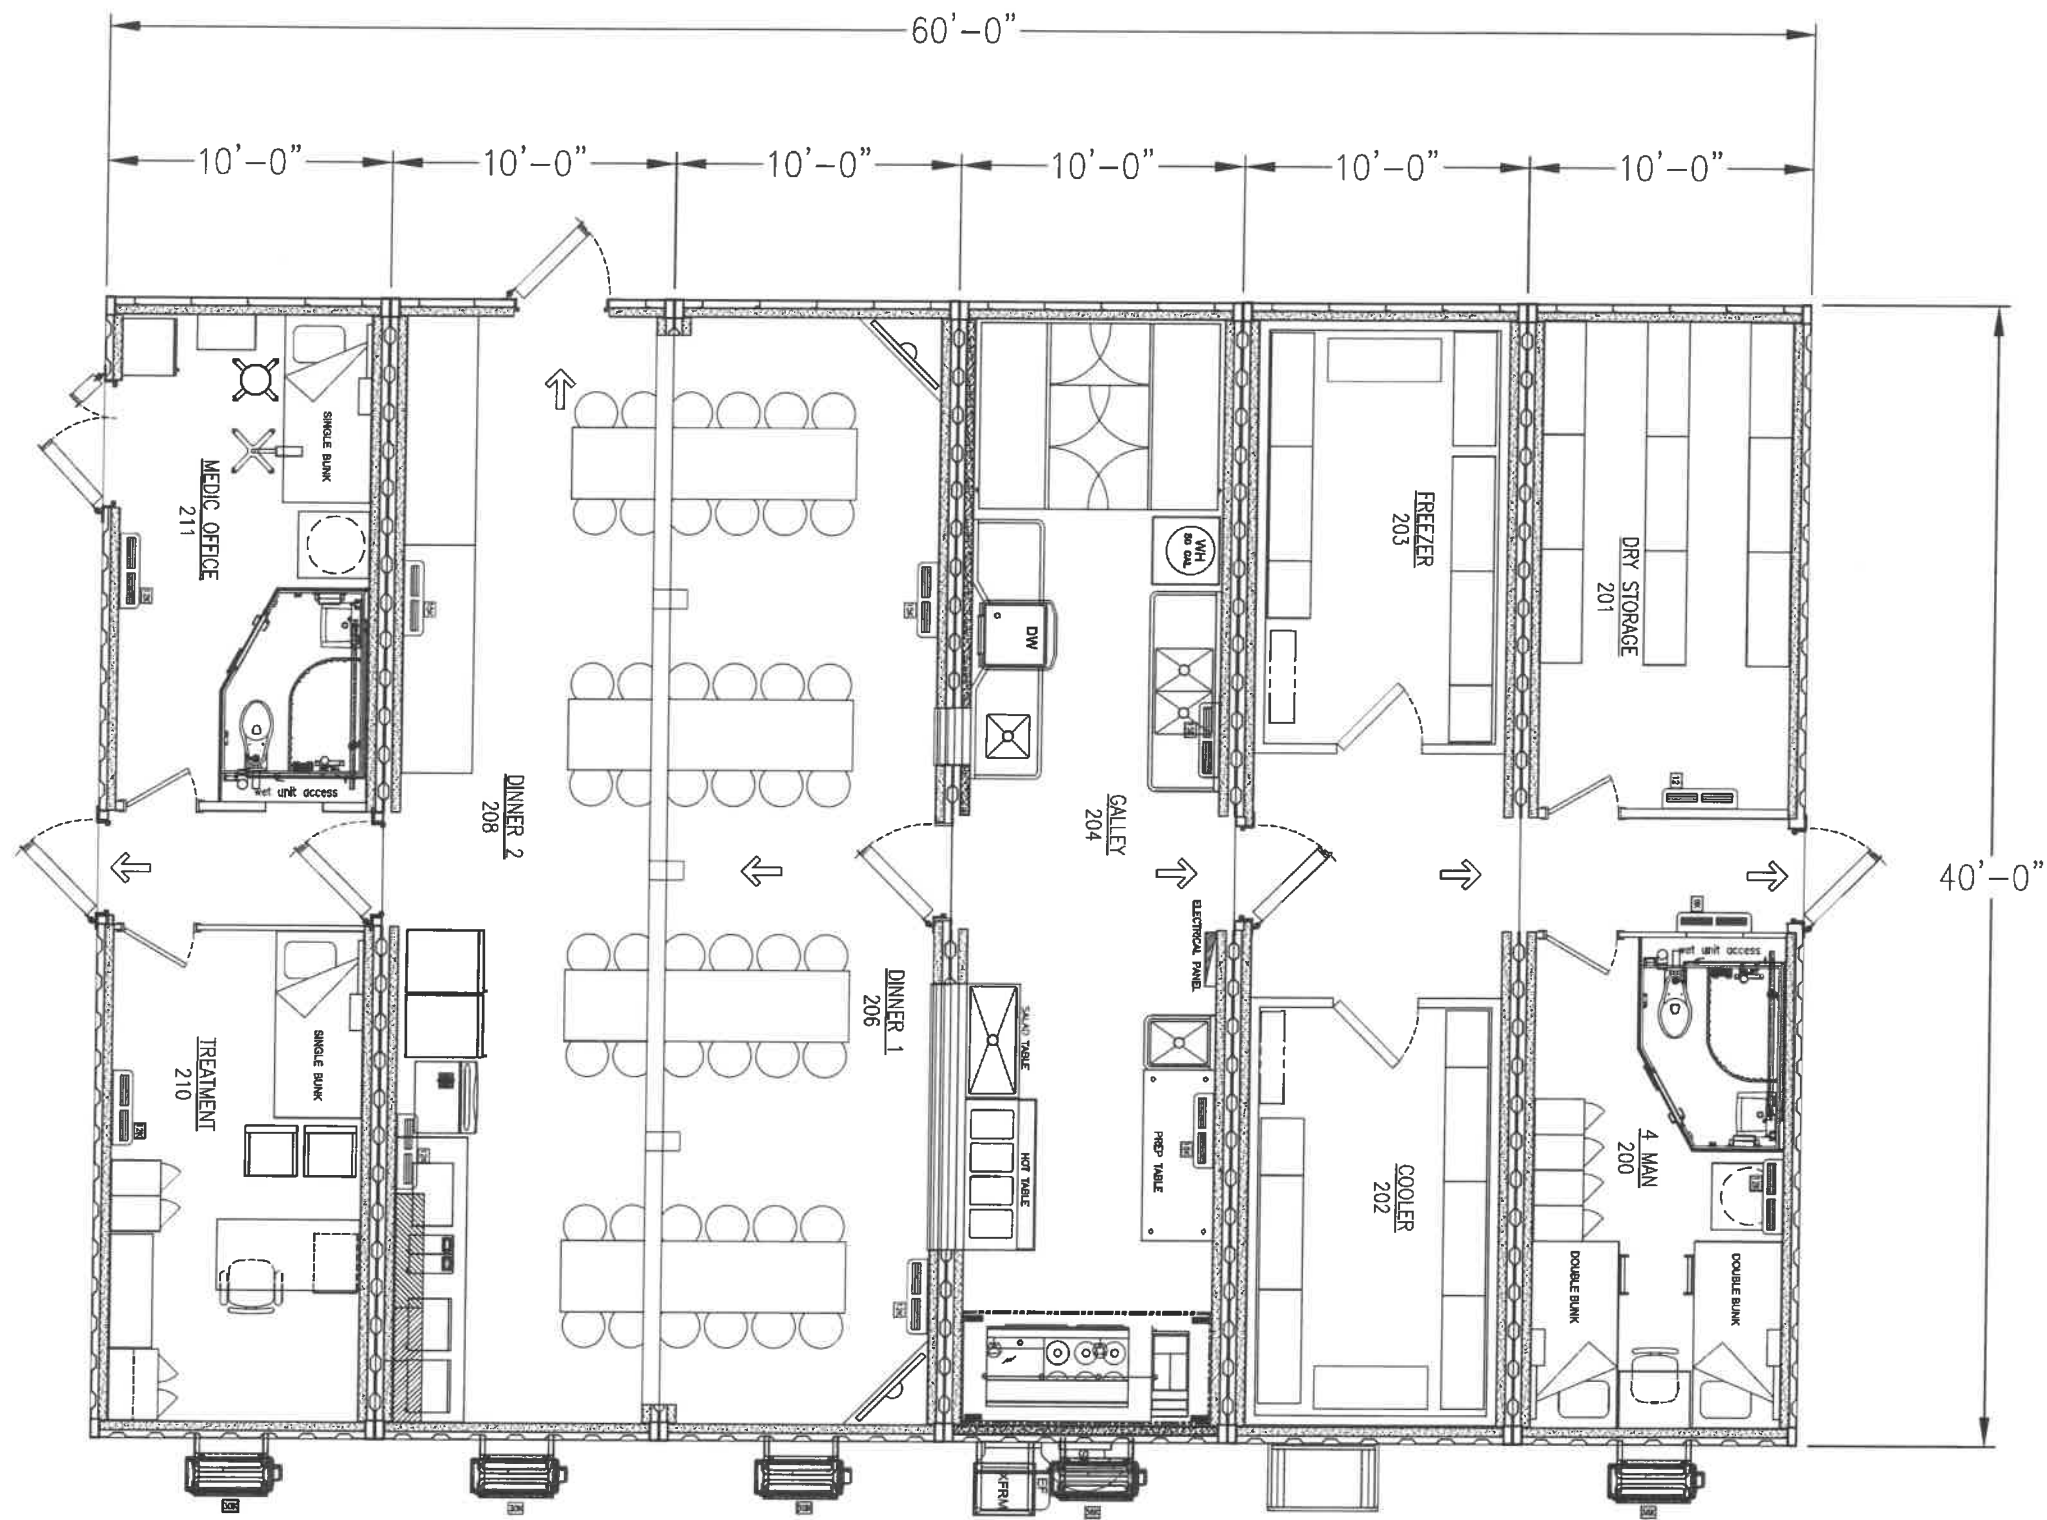

MEDIC OFFICE & TREATMENT RM
(MODULE A12)
(SEE DWG. 00661-312-A12-001)

DINNER #2
(MODULE A11)
(SEE DWG. 00661-312-A11-001)

DINNER #1
(MODULE A10)
(SEE DWG. 00661-312-A10-001)

GALLEY
(MODULE A9)
(SEE DWG. 00661-312-A09-001)

FREEZE & COOLER
(MODULE A8)
(SEE DWG. 00661-312-A08-001)

DRY STORAGE & 4MAN SLPR.
(MODULE A7)
(SEE DWG. 00661-312-A07-001)


LEVEL 2

REV	DESCRIPTION	CH BY	DATE
0	AS BUILT	RC	12/01/15
	REVISIONS		

This drawing shall not be used or reproduced in any manner, nor shall any similar drawings or structures be made herefrom, nor shall the information hereon be used for any purpose other than that for which it is released without the written consent of an officer of

TITLE					
30 MODULE ACOMODATIONS 2ND LEVEL KEY PLAN					
SCALE	DWN BY	CHKD BY	APPR ENG	APP BY	
NONE	ZBG	ABD	HX	RMG	

SHEET
1 OF 1

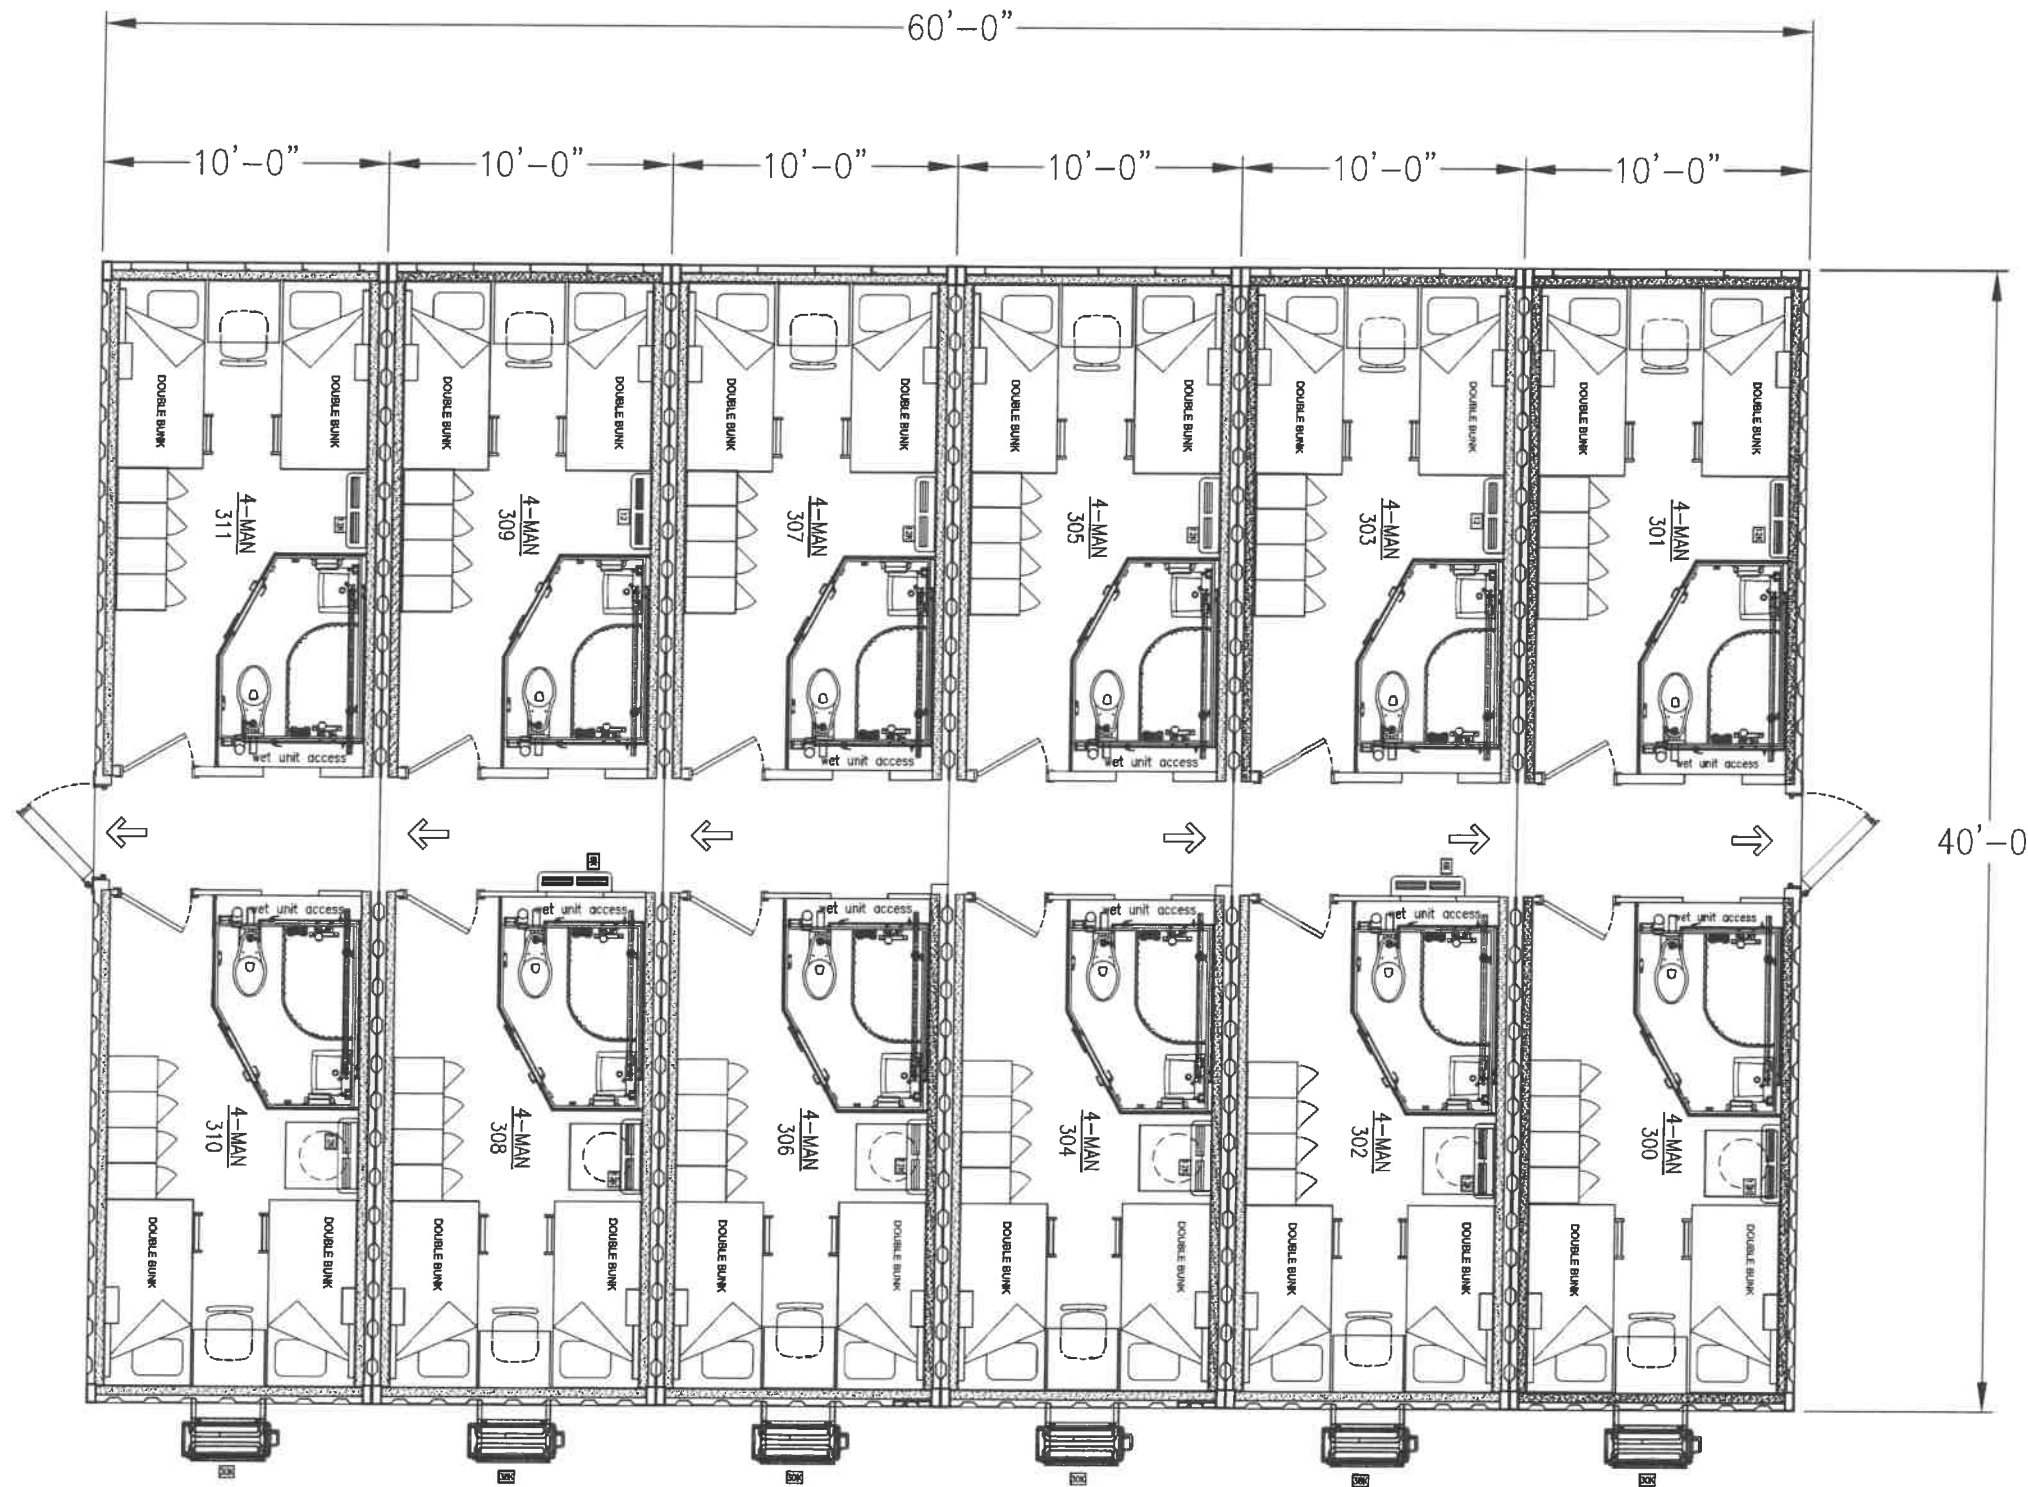

8 MAN SLEEPER
(MODULE A18)
(SEE DWG. 00661-313-A18-001)

8 MAN SLEEPER
(MODULE A17)
(SEE DWG. 00661-313-A17-001)

8 MAN SLEEPER
(MODULE A16)
(SEE DWG. 00661-313-A16-001)

8 MAN SLEEPER
(MODULE A15)
(SEE DWG. 00661-313-A15-001)

8 MAN SLEEPER
(MODULE A14)
(SEE DWG. 00661-313-A14-001)

8 MAN SLEEPER
(MODULE A13)
(SEE DWG. 00661-313-A13-001)

LEVEL 3


This drawing shall not be used or reproduced in any manner, nor shall any similar drawings or structures be made herefrom, nor shall the information hereon be used for any purpose other than that for which it is released without the written consent of an officer of

TITLE
30 MODULE ACOMODATIONS
3RD LEVEL KEY PLAN

SCALE	DWN BY	CHKD BY	APPR	ENG	APP BY
NONE	ZBG	ABD	HX	RMB	

NO	DESCRIPTION	RC	DATE
0	AS BUILT	RC	12/01/15
REV	DESCRIPTION	CH BY	DATE
	REVISIONS		

SHEET
1 OF 1

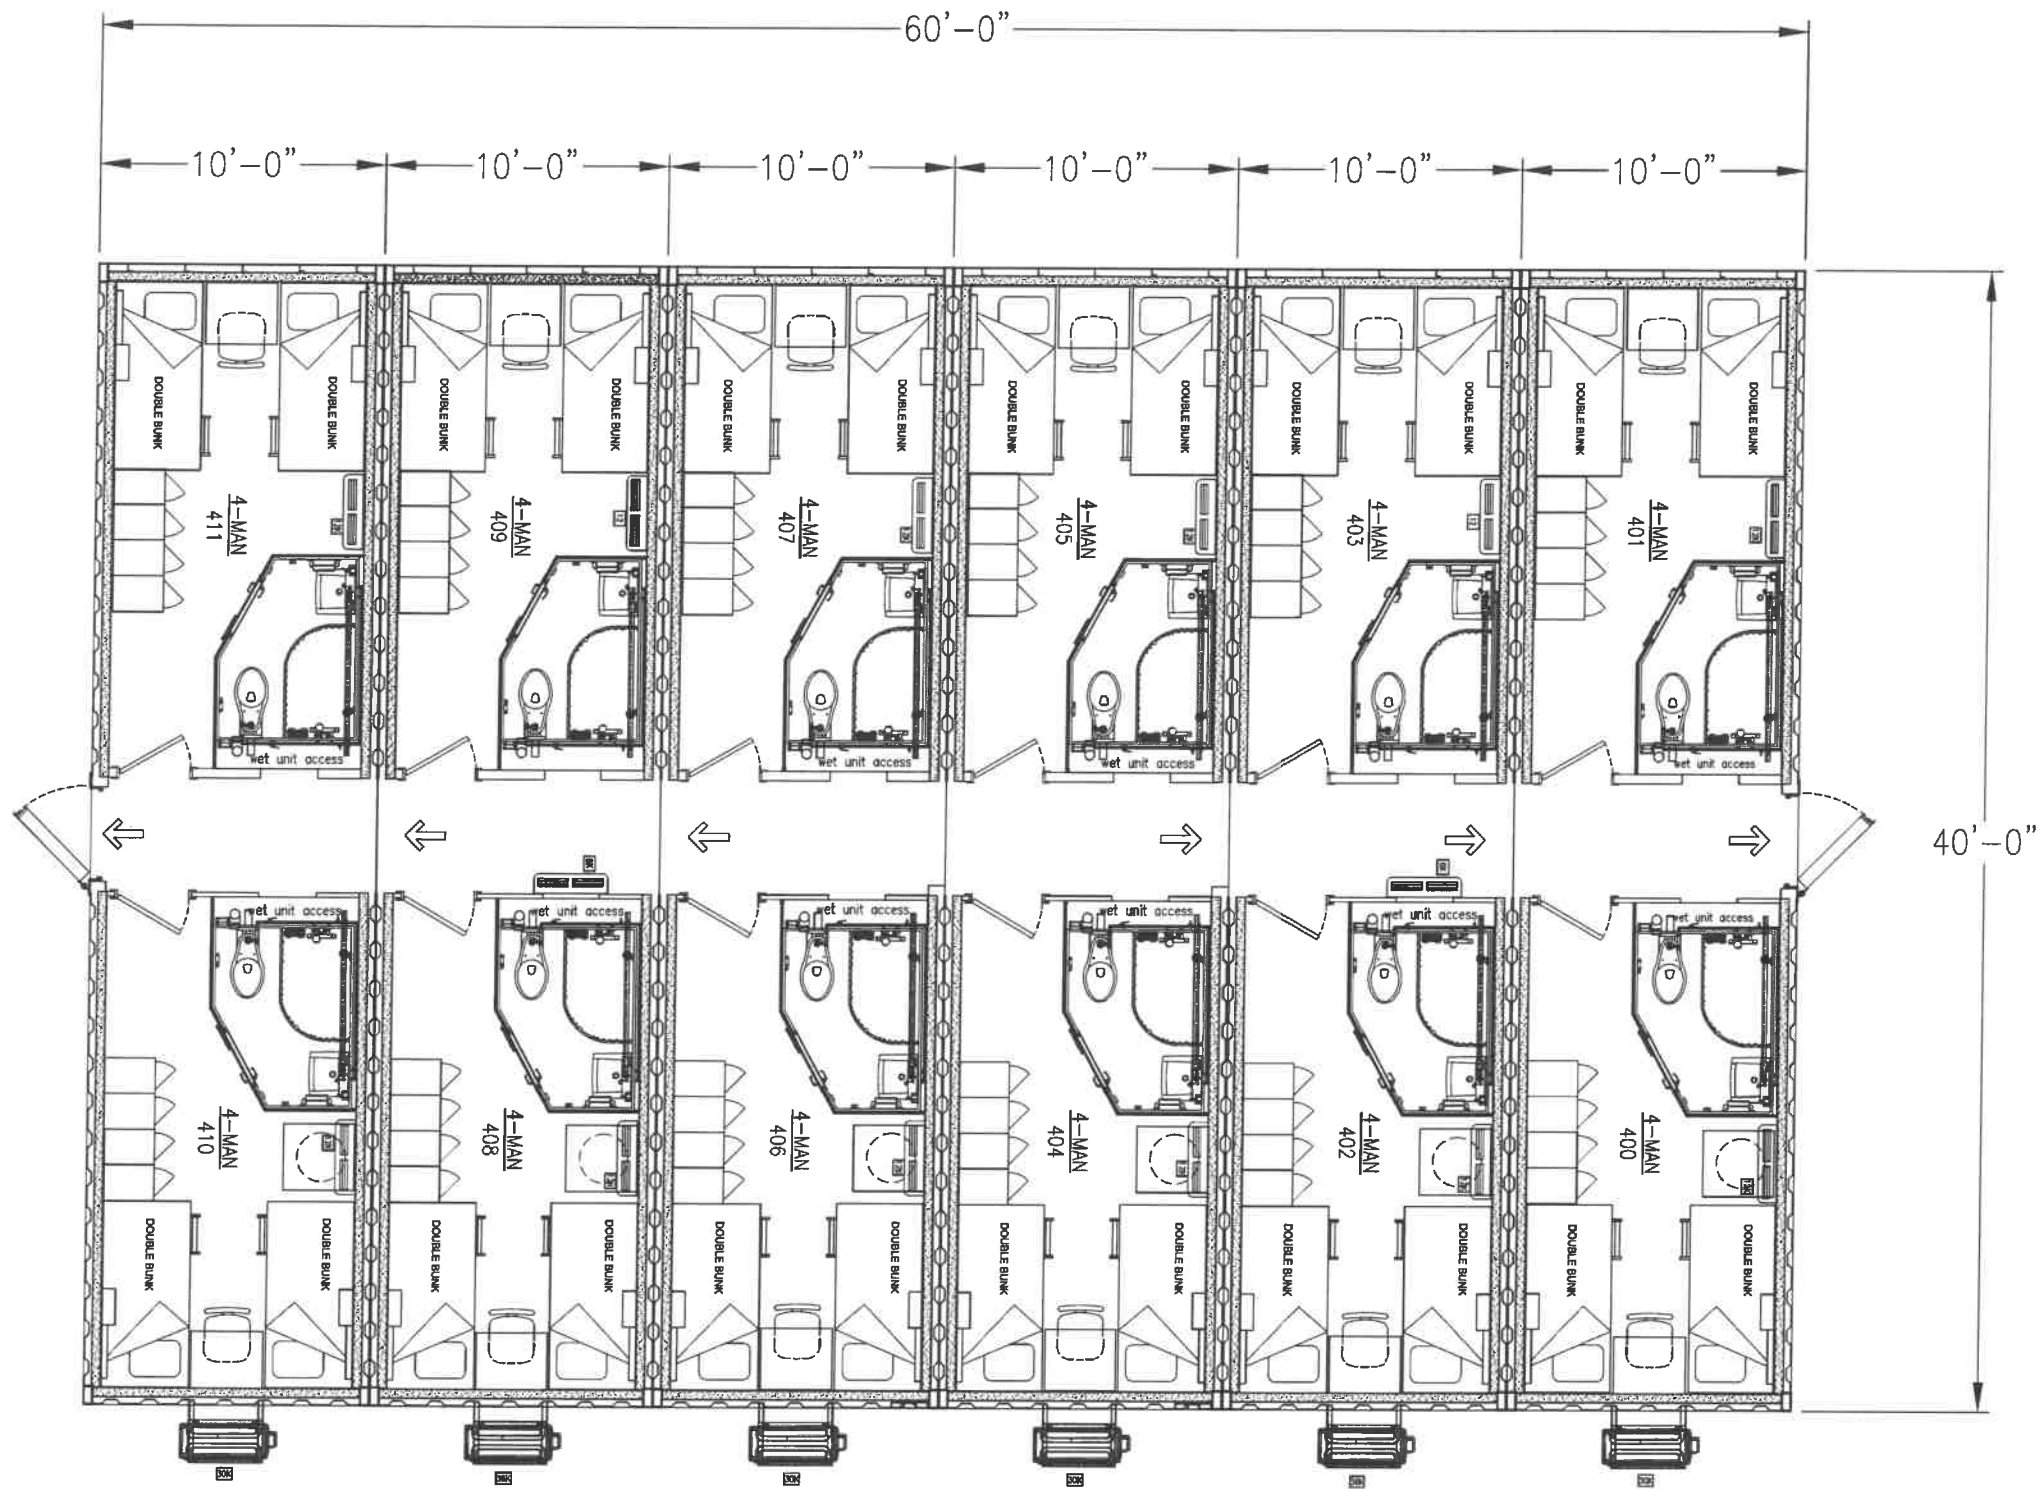


8 MAN SLEEPER (MODULE A24) (SEE DWG. 00661-314-A24-001)
 8 MAN SLEEPER (MODULE A23) (SEE DWG. 00661-314-A23-001)
 8 MAN SLEEPER (MODULE A22) (SEE DWG. 00661-314-A22-001)
 8 MAN SLEEPER (MODULE A21) (SEE DWG. 00661-314-A21-001)
 8 MAN SLEEPER (MODULE A20) (SEE DWG. 00661-314-A20-001)
 8 MAN SLEEPER (MODULE A19) (SEE DWG. 00661-314-A19-001)

LEVEL 4

This drawing shall not be used or reproduced in any manner, nor shall any similar drawings or structures be made herefrom, nor shall the information hereon be used for any purpose other than that for which it is released without the written consent of an officer of

TITLE		30 MODULE ACOMODATIONS 4TH LEVEL KEY PLAN			
SCALE	DWN BY	CHKD BY	APPR	ENC	APP BY
NONE	ZBG	ABD	HX	RMB	
SHEET					REV No
1 OF 1					4 0

0	AS BUILT	RG	12/01/15
REV	DESCRIPTION	CH BY	DATE
	REVISIONS		

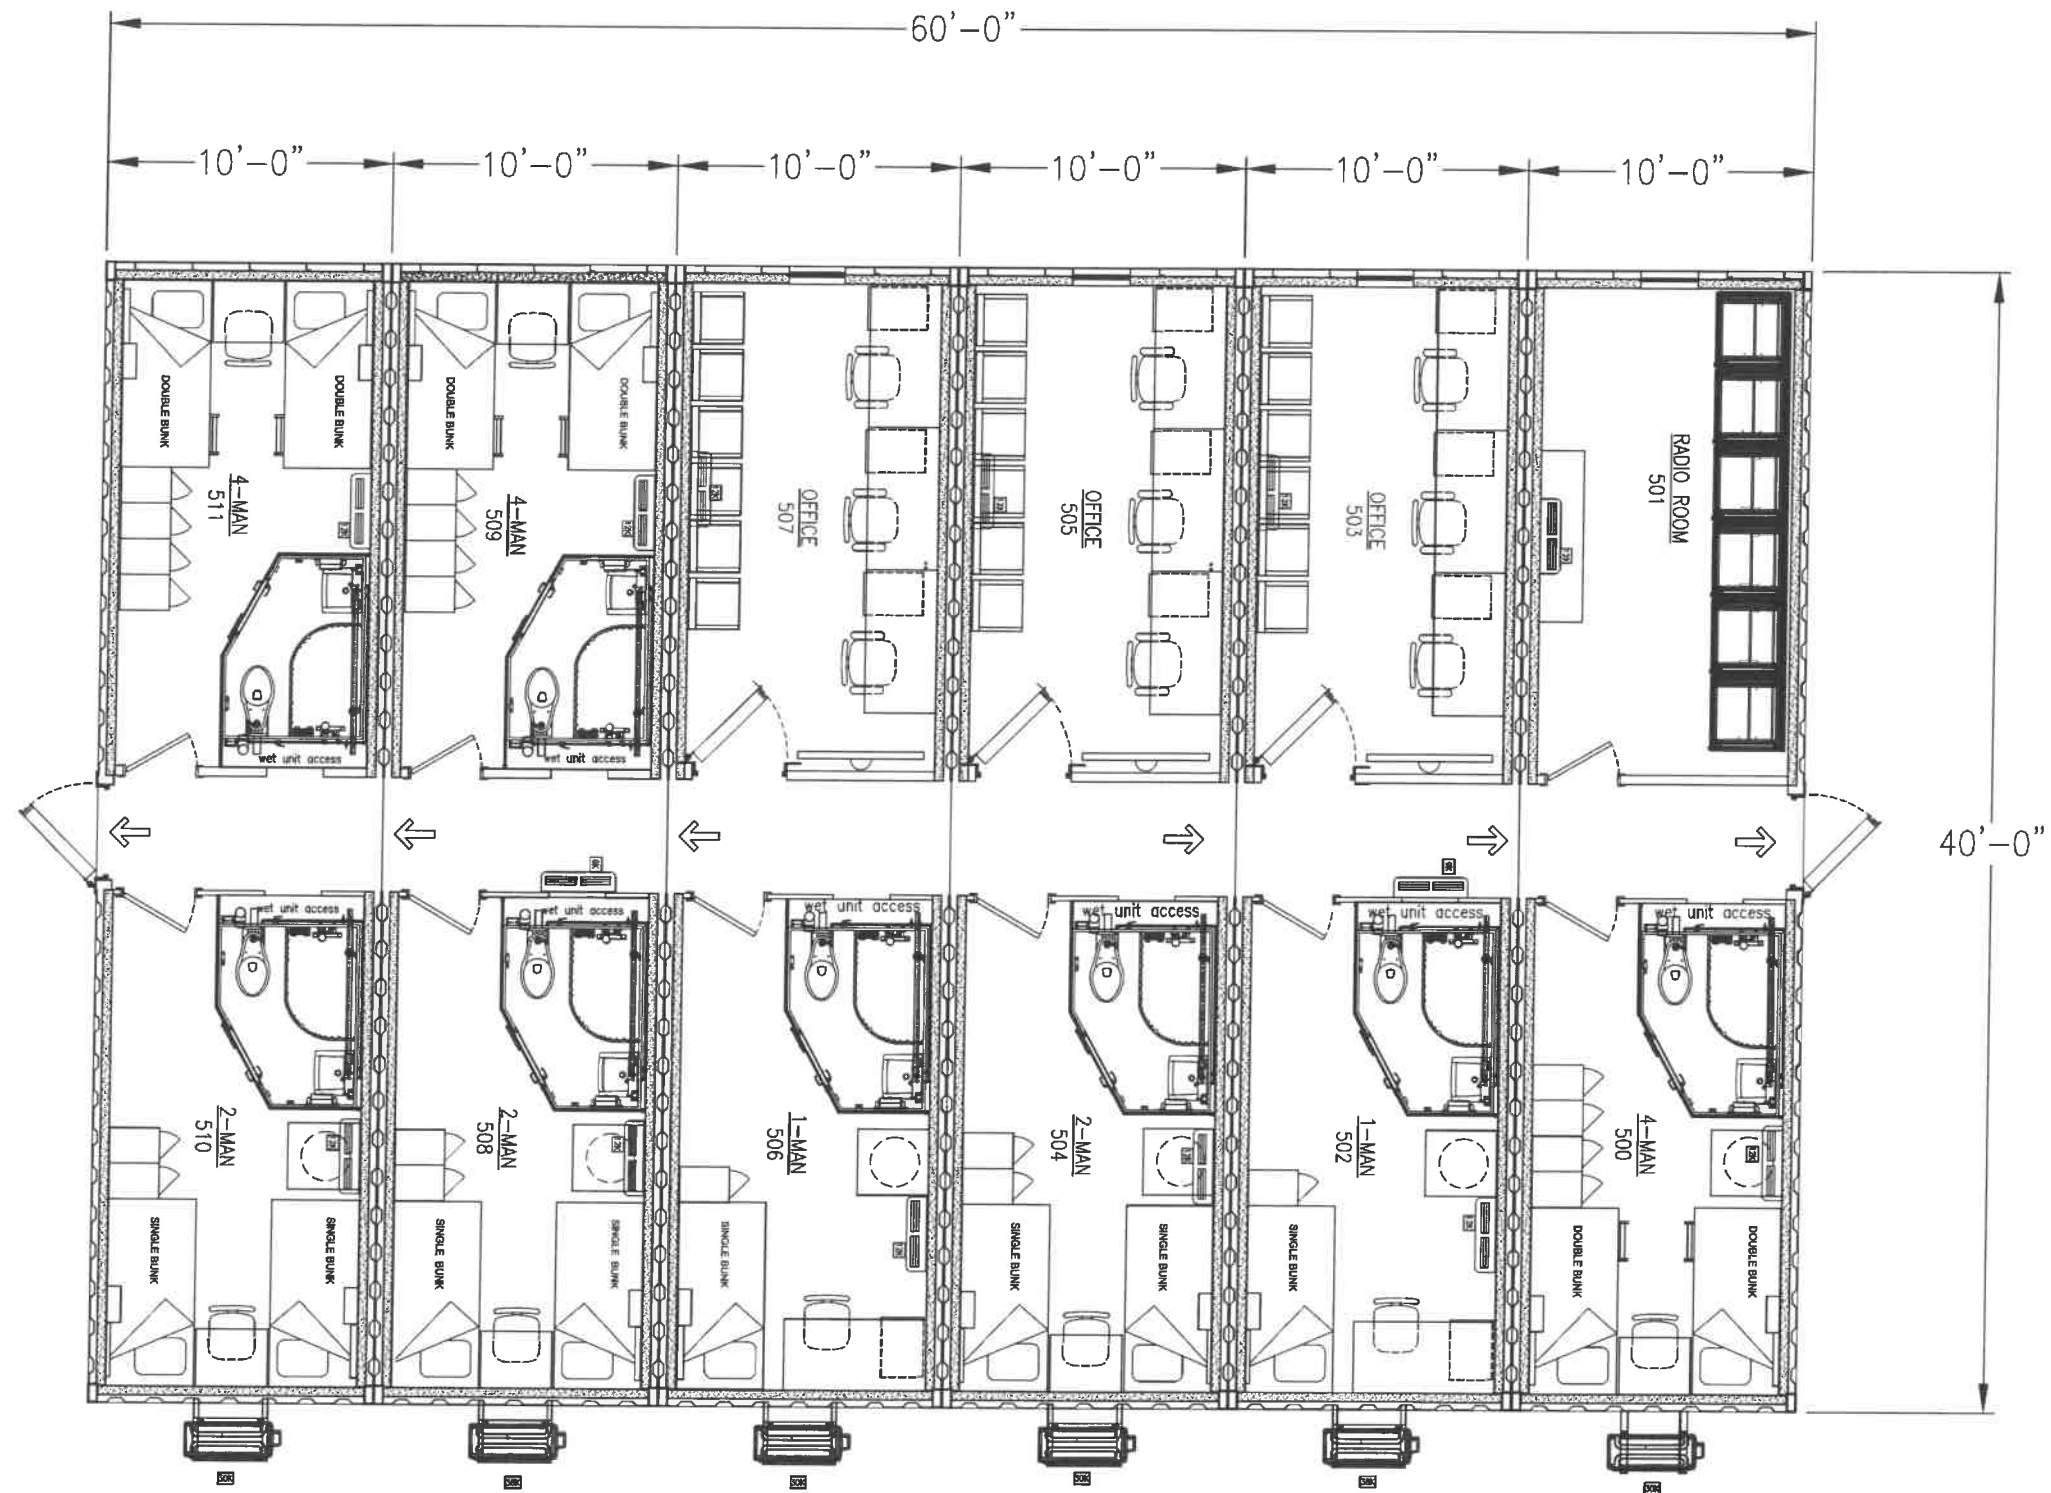

- 4 MAN & 2 MAN SLEEPER**
 (MODULE A30)
 (SEE DWG. 00661-315-A30-001)
- 4 MAN & 2 MAN SLEEPER**
 (MODULE A29)
 (SEE DWG. 00661-315-A29-001)
- OFFICE & 1 MAN SLEEPER**
 (MODULE A28)
 (SEE DWG. 00661-315-A28-001)
- OFFICE & 2 MAN SLEEPER**
 (MODULE A27)
 (SEE DWG. 00661-315-A27-001)
- OFFICE & 1 MAN SLEEPER**
 (MODULE A26)
 (SEE DWG. 00661-315-A26-001)
- RADIO & 4 MAN SLEEPER**
 (MODULE A25)
 (SEE DWG. 00661-315-A25-001)

LEVEL 5

This drawing shall not be used or reproduced in any manner, nor shall any similar drawings or structures be made herefrom, nor shall the information herein be used for any purpose other than that for which it is released without the written consent of an officer of

30 MODULE ACOMODATIONS 5TH LEVEL KEY PLAN	
TITLE Jobs and Proposals	SCALE: NONE DRAWING NUMBER:
SHEET: 1 OF 1	REV No: 0

REV	DESCRIPTION	CH BY	DATE
0	AS BUILT	RG	12/01/15